


- LEGEND**
- INDICATES NEW WORK TO BE PERFORMED UNDER THIS CONTRACT
 - INDICATES CONSTRUCTION NOTE NUMBER OR PLANT CODE DESIGNATION
 - S. M. H. SUPER METAL HALIDE
 - DISP PRODUCT DISPENSER
 - F FILL MANHOLE
 - ASM/RES ANNULAR SPACE MONITOR/RESERVOIR
 - V VENT
 - DB DRYBREAK MANHOLE
 - S/P SUBMERSIBLE PUMP
 - G GAUGE MANHOLE
 - S SIPHON
 - VRI STAGE I VAPOR RECOVERY
 - VRII STAGE II VAPOR RECOVERY
 - NEW 6" CONC. CURB
 - CONC. CURB (TO REMAIN)
 - CONC. CURB (TO BE REMOVED)
 - NEW DEPRESSED CONC. CURB
 - DEPRESSED CONC. CURB (TO REMAIN)
 - DEPRESSED CONC. CURB (TO BE REMOVED)
 - EXISTING GRADES
 - PROPOSED GRADES
 - SA SANITARY SEWER
 - G GAS
 - ST STORM SEWER
 - W WATER
 - T TELEPHONE
 - E ELECTRIC
 - FENCE
 - GUIDE RAIL
 - CONDUITS
 - CO CLEAN OUT
 - PARKING SPACE NUMBER
 - TANK NUMBER
 - UTILITY POLE

MIDDLESEX TURNPIKE

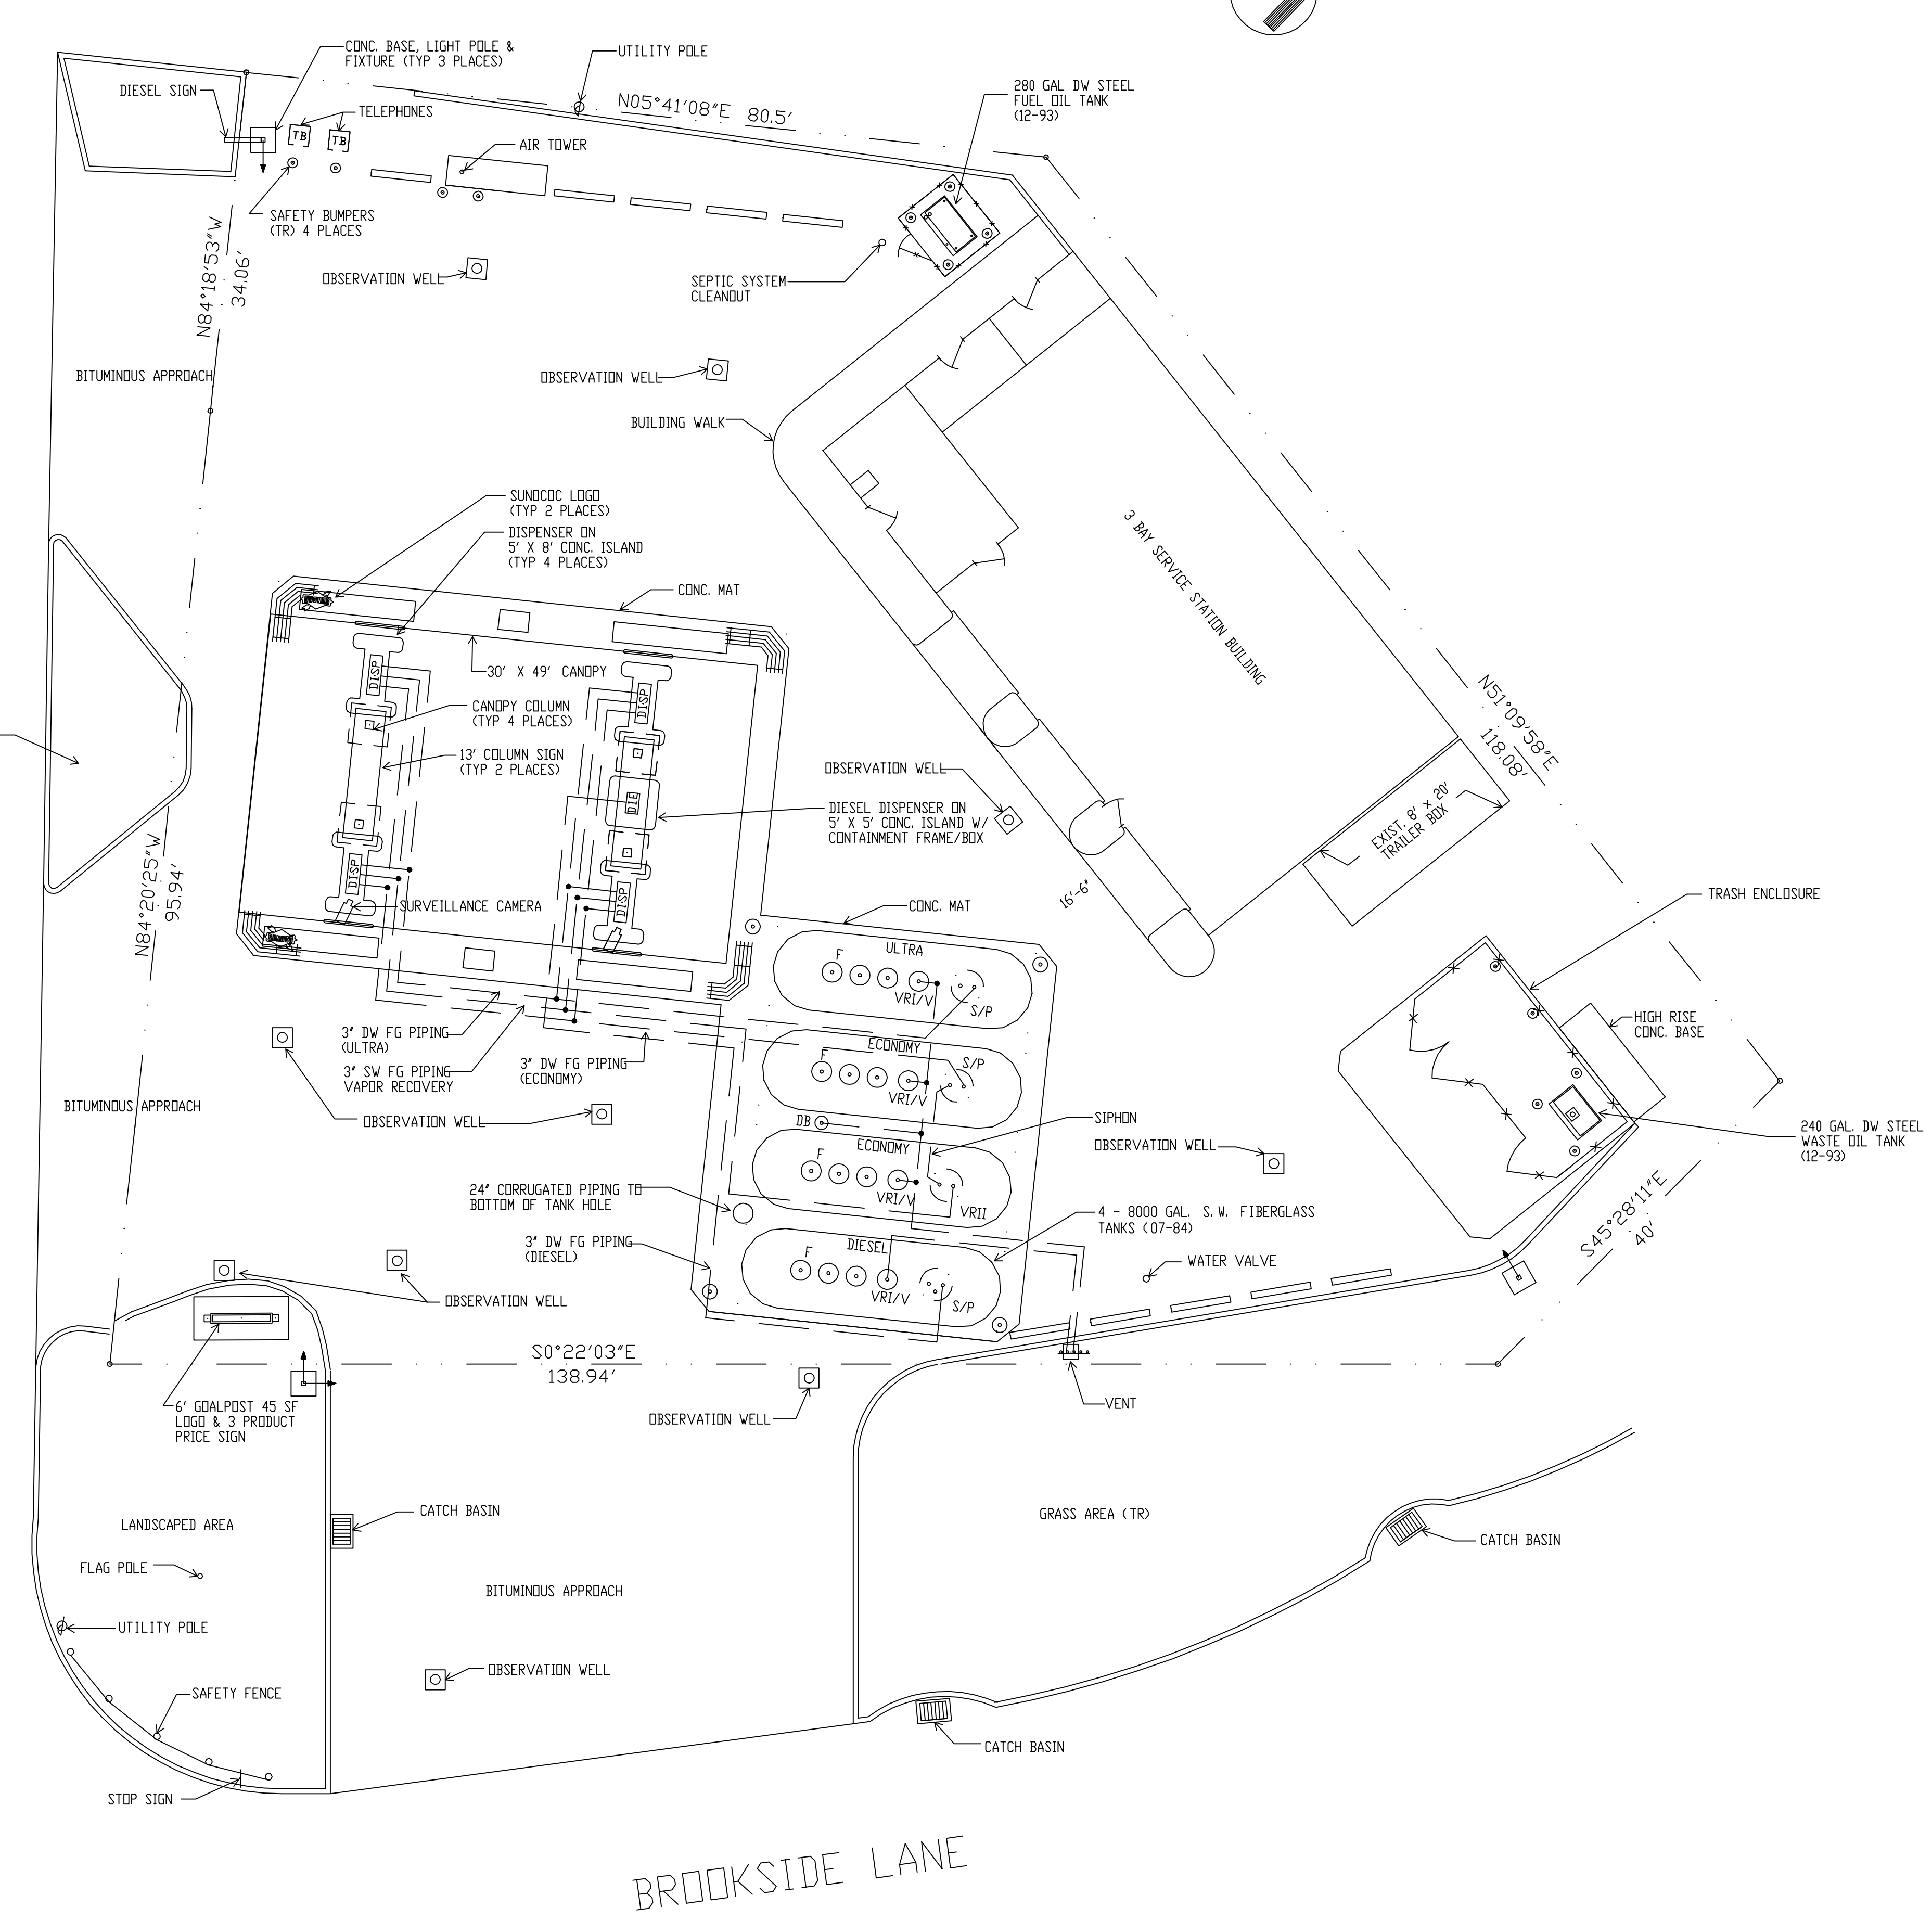

It is understood that the drawing(s), specifications, CAD files, paper documents and electronic documents ("documents") are prepared specifically for use with this Project and are the sole property of Sunoco, Inc. They are not intended or represented to be suitable for reuse by others on any other project or for any other purpose. Use of the Documents, information or data contained therein for other purposes is at the sole risk and responsibility of the user. Reuse will be at the sole risk of the user and without liability or legal exposure to Sunoco, Inc. Sunoco, Inc. will be indemnified and held harmless from all claims, damages, losses and expenses arising out of or resulting therefrom.
Sunoco, Inc.

2	04-07-1994	REVISED PER AS-BUILT PER PROJECT 52902	MTH		
REV. NO.	DATE	REVISIONS	DRAWN BY	CHKD BY	APPV'D
SUN COMPANY, INC. (R&M) Marketing Engineering Department Philadelphia, PA					
LOCATION: MIDDLESEX TPKE. & BROOKSIDE LN ESSEX, CT			PROJECT NO.		
PLOT PLAN AS BUILT					
APPROVED: CHECKED D. HICKS DRAWN B. SCHINDLER DATE 06-10-93			FACILITY NO. 0005-6994	DRAWING NO. P-1	REV. NO. 2

THIS DRAWING IS AND SHALL REMAIN THE PROPERTY OF SUN COMPANY, INC. (R&M). NO REPRODUCTION OR ALTERATION OF THIS DRAWING WITHOUT THE EXPRESSED WRITTEN PERMISSION OF SUN COMPANY, INC. (R&M) IS PROHIBITED.