


200' RADIUS PERIMETER MAP
(SCALE 1"=80')

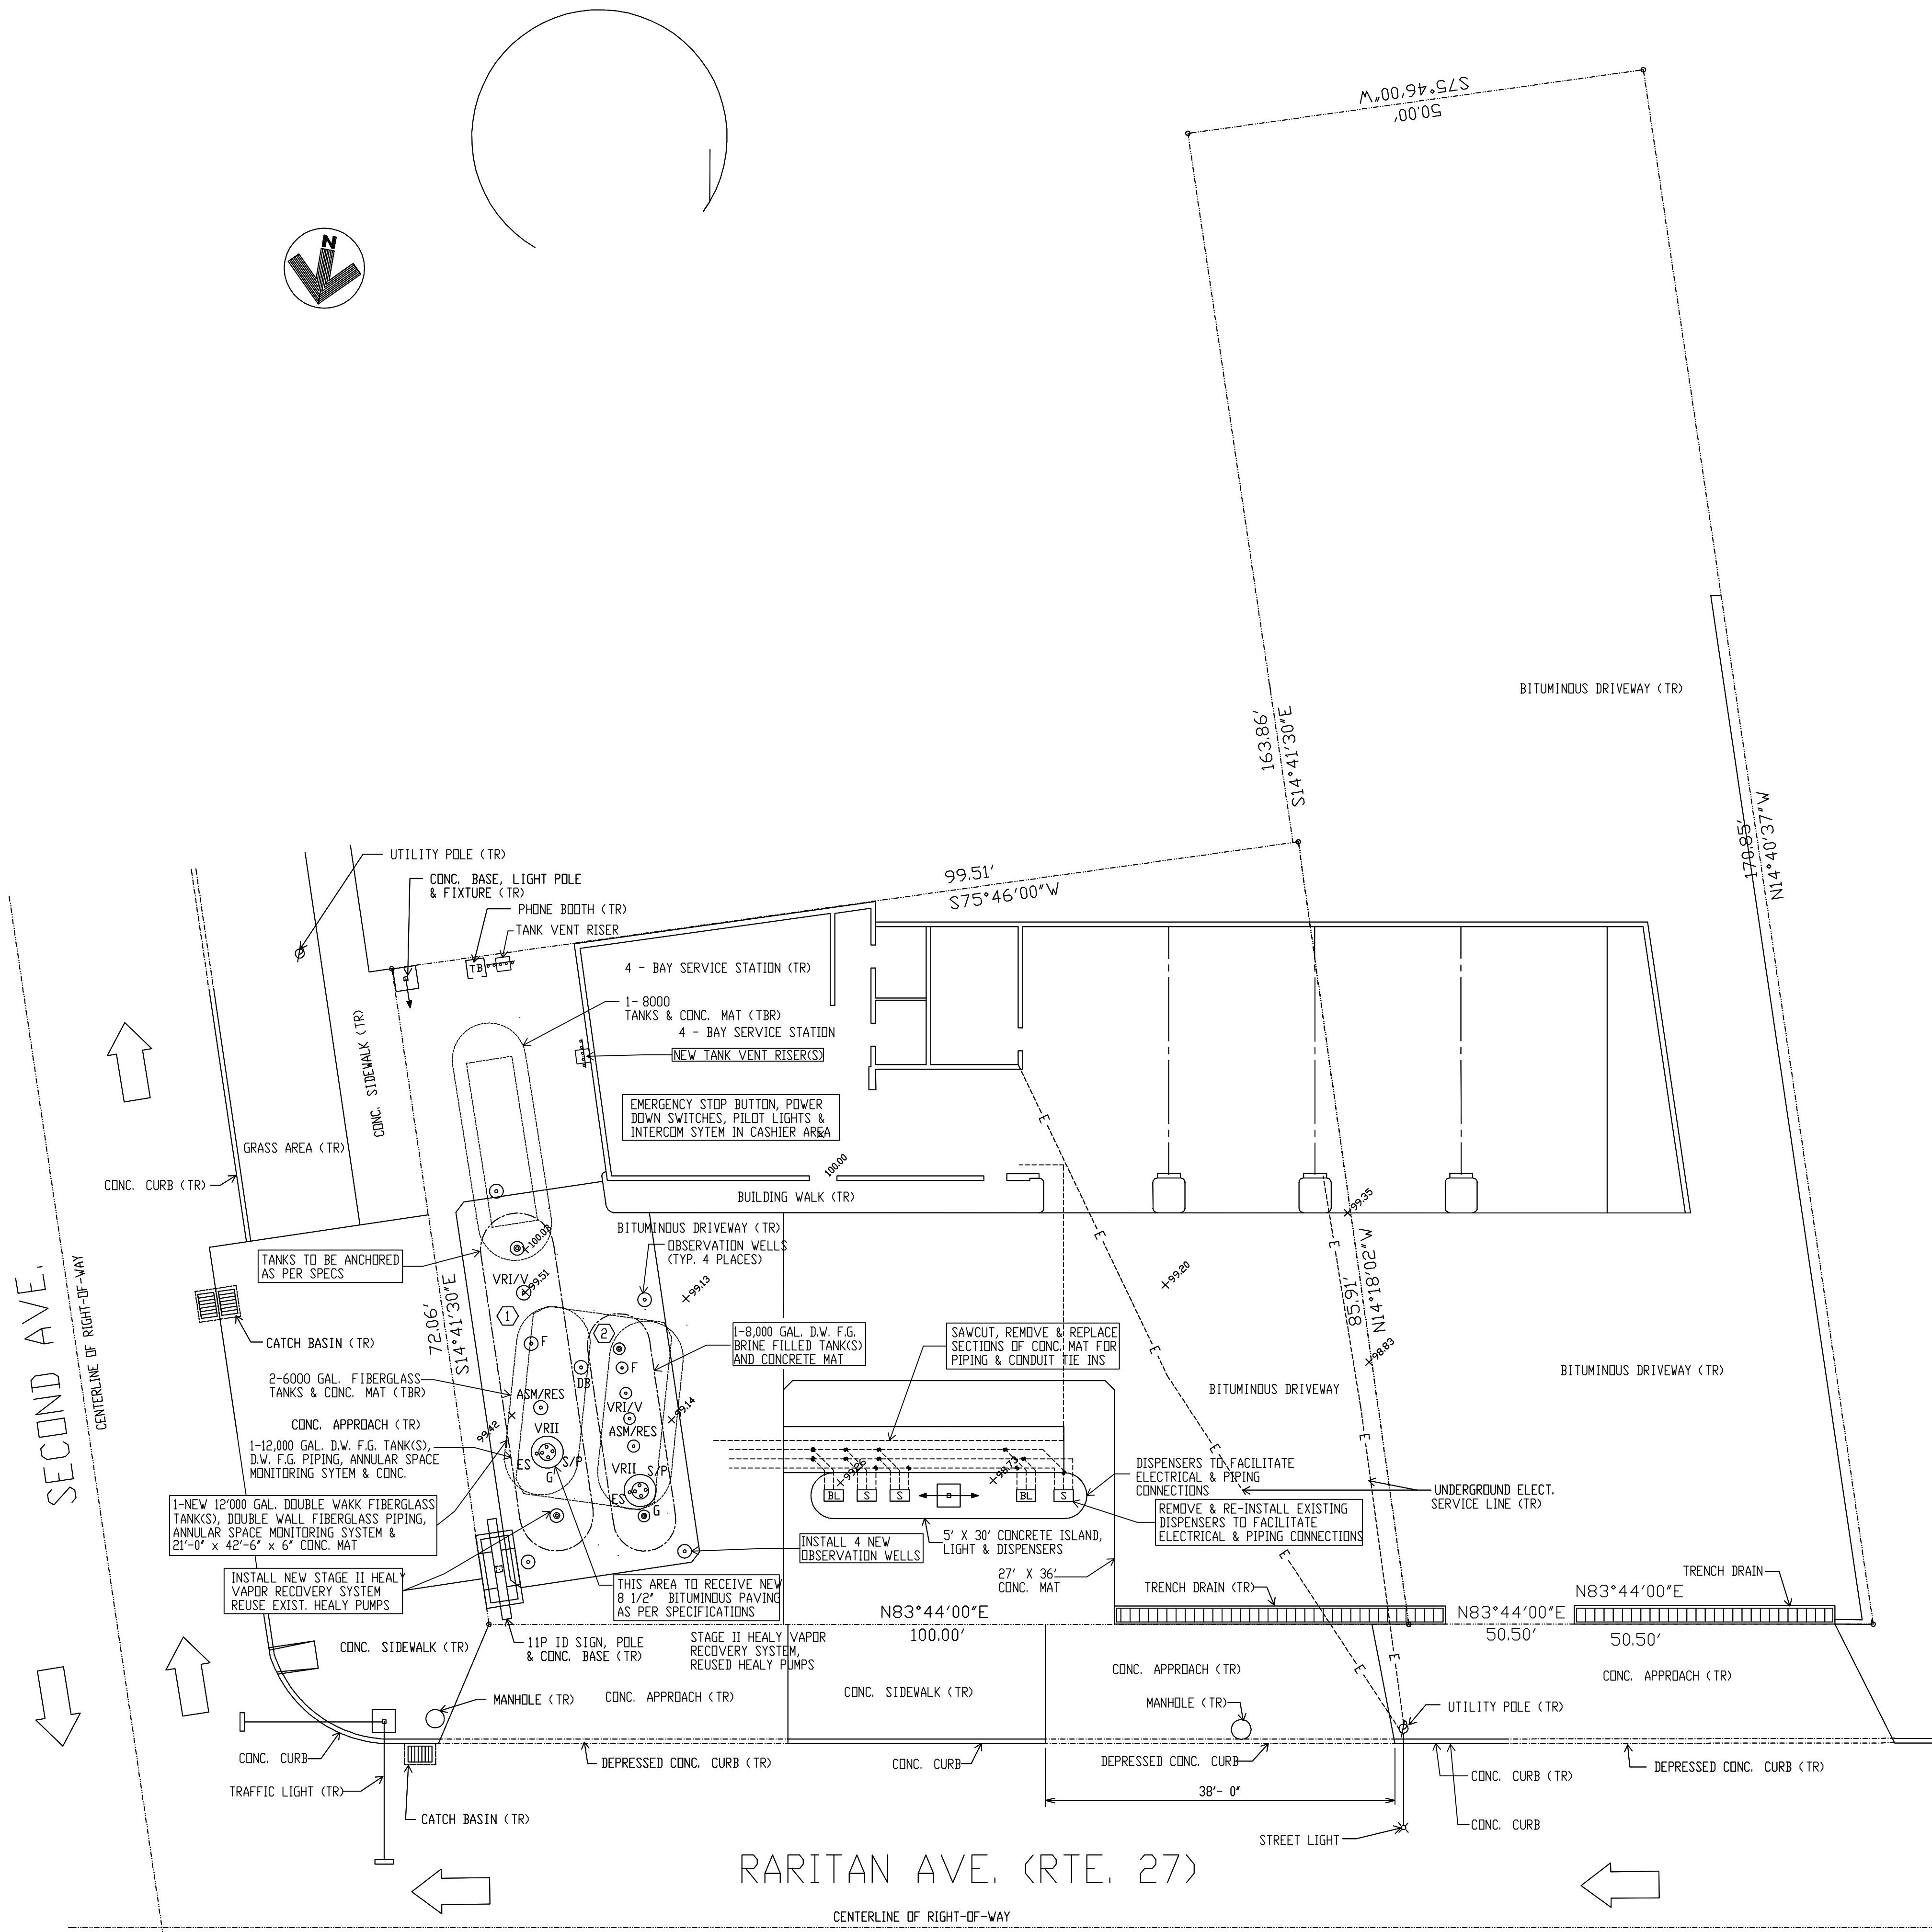

ALL EXCAVATED AREAS TO BE BACKFILLED WITH ENGINEER APPROVED MATERIAL, AND COMPACTED TO 98% STANDARD PROCTOR AT OPTIMUM MOISTURE CONTENT PRIOR TO PAVING.

- REFERENCE DRAWINGS**
- 2-305 SERVICE STATION BUILDING - RETRO-FIT ELECTRICAL
 - 2-320 EMERGENCY STOP/START & DISPENSER SHUT-DOWN SCHEMATIC
 - 2-326 INTERCONNECTION WIRING DIAGRAM FOR RETRO-FIT SINGLE REMOTE
 - 2-328 INTERCONNECTION WIRING DIAGRAM FOR RETRO-FIT BLENDER REMOTE
 - 2-350 FIELD WIRING DIAGRAM FOR DISPENSING EQUIPMENT
 - 2-350 STAGE II VAPOR RECOVERY PIPING & DETAILS - (HEALY CENTRAL SYSTEM)-422
 - 3-450 FIBERGLASS TANKS & DETAILS - DOUBLE WALL TANKS
 - 3-451 EQUIPMENT & PRODUCT SPECS - DOUBLE WALL PIPING
 - 3-452 DISPENSER CONTAINMENT PIPING - DOUBLE WALL PIPING
 - 4-501 EXTERIOR CONCRETE DETAILS

- LEGEND**
- NOTES**
- INDICATES NEW WORK TO BE PERFORMED UNDER THIS CONTRACT
 - INDICATES CONSTRUCTION NOTE NUMBER OR PLANT CODE DESIGNATION
 - (TR) TO REMAIN
 - (TBR) TO BE REMOVED
 - S.M.H. SUPER METAL HALIDE
 - DISP. PRODUCT DISPENSER
 - F. FILL MANHOLE
 - ASM/RES. ANNULAR SPACE MONITOR/RESERVOIR
 - V. VENT
 - DB. DRYBREAK MANHOLE
 - S/P. SUBMERSIBLE PUMP
 - G. GAUGE MANHOLE
 - S. SIPHON
 - ES. ELECTRONIC SUMP SENSOR
 - VR/I. STAGE I VAPOR RECOVERY
 - VR/II. STAGE II VAPOR RECOVERY
 - NEW 6" CONC. CURB
 - CONC. CURB (TR)
 - CONC. CURB (TBR)
 - NEW DEPRESSED CONC. CURB
 - DEPRESSED CONC. CURB (TR)
 - DEPRESSED CONC. CURB (TBR)
 - EXISTING GRADES
 - PROPOSED GRADES
 - SA. SANITARY SEWER
 - G. GAS
 - ST. STORM SEWER
 - W. WATER
 - T. TELEPHONE
 - E. ELECTRIC
 - F. FENCE
 - GLIDE RAIL
 - CONDUITS
 - C. CLEAN OUT
 - P. PARKING SPACE NUMBER
 - X. TANK NUMBER

GENERAL CONTRACTOR SHALL CONTACT GARDEN STATE UNDERGROUND PLANT LOCATION SERVICE, INC. 72 HOURS PRIOR TO EXCAVATION AT 1-800-272-1009

ABOVE AND UNDERGROUND STORAGE TANK LEGEND

TANK	STAT	TYPE	CAPACITY	PRODUCT	STATUS	PIPING	STATUS	INST. DATE
1	NEW	DBL WALL FG	2000	GASOLINE	NEW	DBL WALL	NEW	
2	NEW	DBL WALL FG	8000	DIESEL	NEW	DBL WALL	NEW	

1	10-14-98	ADDED AS-BUILT INFORMATION TO PLOT PLAN (CREATED EXISTING CONDITION PLAN PER-1)	KAP	NNV	
REV. NO.	DATE	REVISIONS	DRAWN BY	CHECKED BY	APPROVED BY
SUN COMPANY, INC. (R&M) Marketing Engineering Department Philadelphia, PA					
LOCATION: RARITAN AVE. (RT. 27) HIGHLAND PARK, N.J.				PROJECT NO. 52879	
PLOT PLAN WITH AS-BUILT PLAN					
APPROVED: [Signature]			FACILITY NO. 0007-6406		DRAWING NO. P-1
CHECKED: [Signature]			DATE: 04-08-93		REV. NO. 1

THIS DRAWING IS AND SHALL REMAIN THE PROPERTY OF SUN COMPANY, INC. NO REPRODUCTION OR ALTERATION OF THIS DRAWING WITHOUT THE EXPRESSED WRITTEN PERMISSION OF SUN COMPANY, INC. 1990 IS PROHIBITED.